



MV JATI EIGHT

SFCB /UTILITIES VESSEL

General

Owners	: Dinastia Jati Sdn Bhd
IMO No.	: 9683934
Official Number	: 335549
Builder	: Strategic Marine (Singapore) Ltd.
Built	: 2013
Flag / Port of Registration	: Malaysia / Port Klang
Call sign	: 9MQU2
Classification	: Bureau Veritas (BV)

Dimension

Tonnage	- GT	: 254 T
	- NT	: 76 T
Length	- Overall	: 40.37 m
Beam	- Moulded	: 7.50 m
Depth		: 3.30 m
Draft		: 1.60 m

Capacities

Cargo Deck Space	: 108.00m ²
Strength	: 2 T/m ²
Reefer Point	: 2 nos on deck (220/440 VAC)
Portable Water Tanks	: 28 m ³
Fuel Oil Tanks	: 60 m ³
Lubrication Oil	: 200 litres
Cargo Weight.	- Maximum : Approx. 44 T
Deadweight.	- Maximum : TBA
	- Light displacement : TBA

Propulsion

Main Engine	- Type	: 2 x Cummins KTA38M2 Tier 2
		: 1 x Cummins KTA50M2 Tier 2
	- BHP	: 2 x 1350 BHP & 1 x 1800 BHP
		Total: 4500 BHP (3350 Kw)
Propellers		: 3 x Fixed Pitch Propeller (FPP)
Bow Thruster		: 2 MT lateral thrust
Controls		: 2 control stands
Starter		: Electrical
Reduction Gear & Ratio		: Twin Disc, MG 6690 & 6848
Speed / Consumption - Maximum		SC, 2.47:1
ltr/hr		: 26.07 Knots @ 100% / Approx
	- Cruising	: 25.01 knots @ 85% MCR/Approx
		786 ltr/hr
	- Genset	: Approx 25 ltr/hr

Generators	- Type	: 2 x CUMMINS BT 5.9 D(M)
	- kW	: 2 x 80 kW
	- Voltage	: 415 V
	- Phase	: 3 phases
	- Hz	: 50 Hz

Accommodation

Cabin/ Berth	: 7 nos / 14 units (4 berths x 1 nos) (2 berths x 4 nos) (1 berths x 2 nos)
Crew	: 10 pax
Passengers	: 70 pax (Business Class inclined seat with individual hand rest, Fully Air- conditioning.

Life Saving Equipment

Water Curtain	: All around accommodation
Inflatable Life Rafts	: 20 men x 8 nos.
Rescue Boat	: 6 men x 1 Semi-Rigid rescue boat c/w 25hp outboard engine
Ring Buoys	: 8 nos
Man Over Board Marker	: 2 nos
Life Jackets / Work Vests	: 80 nos, (SOLAS approved) / 12 nos
SART	: 2 nos
EPIRB	: 1 no
Line Throwing Apparatus	: 1 set (4 projectiles & 4 lines)

Fire Fighting Equipment

Fire Extinguishers	: As per SOLAS
Fireman Outfit	: 2 nos
Breathing Apparatus	: 2 sets of SCBA

Navigation & Communication

As per SOLAS

Others

Bilge Pump / Ballast Pump	: 30 m ³ /hr @ 54 m head
Fire Pump	: 30 m ³ /hr @ 54 m head Fresh Water
Transfer Pump	: 13.5 m ³ /hr @ 55 m head
Fuel Transfer Pump	: 13.5 m ³ /hr @ 54 m head
Anchor Weight	: 255kg HHP
Anchor Windlass	: DOUBLE GYPSOY TWIN WARPING HEAD
Stove (cooker)	: 1 unit Electric 4 burner cook top
Dry Store	: 1 x 4 m ³
Fridge	: 1 x 5 m ³
Freezer	: 1 x 3 m ³
Washing machine	: 1 x 7kg
Dryer	: 1 x 7kg
Rescue Zone	: 2
Hospital / Owner Cabin	: 3






3A-6A, Jalan PJU 8/3A, Damansara
Perdana, 47820 Petaling Jaya,
Selangor, Malaysia.

+603 7722 3842

chartering@dinastiajati.com



PRINCIPAL PARTICULARS			
LENGTH O.A.	m	40.37	
BEAM MOULDED	m	7.5	
DEPTH MOULDED	m	3.2	
GRT		238	
DRAFT. MAX BL	m	1.72	
DRAFT. MAX PROP	m	2.35	
CLEAR DECK	m'	96	
FUEL OIL	m'	60.0	
LUBE OIL	m'	0.8	
FRESH WATER	m'	28.3	
BLACK WATER	m'	0.5	
GREY WATER	m'	1.0	
PASSENGERS		70	
CREW		10	
DECK STRENGTH	t/m'	2.0	
MAX DEAD WEIGHT	t	95	
PROPULSION	bhp	4500	
BOW THRUSTER	bhp	2x150	
SPEED (85%MCR, 50dwt)	kts	25	

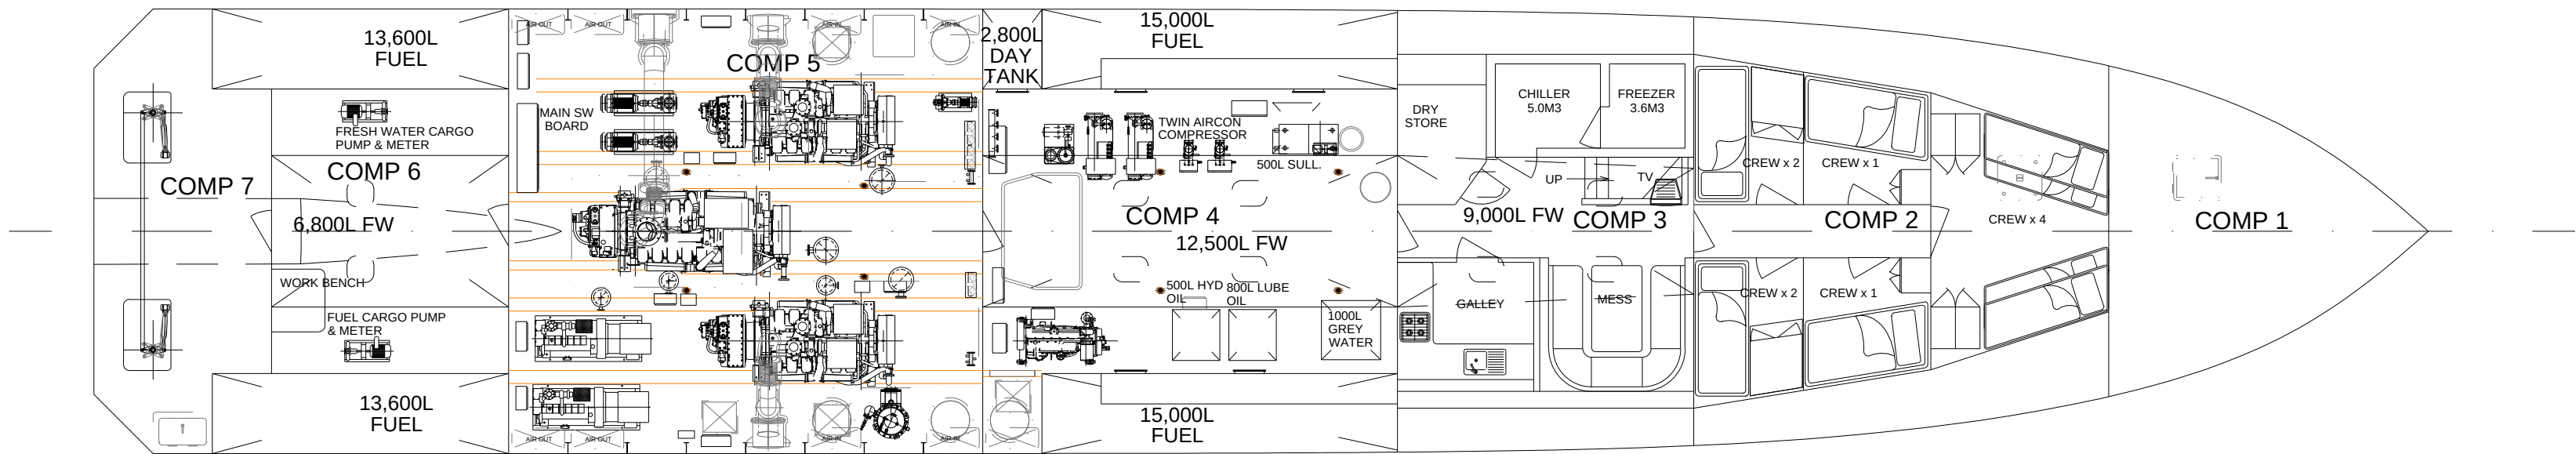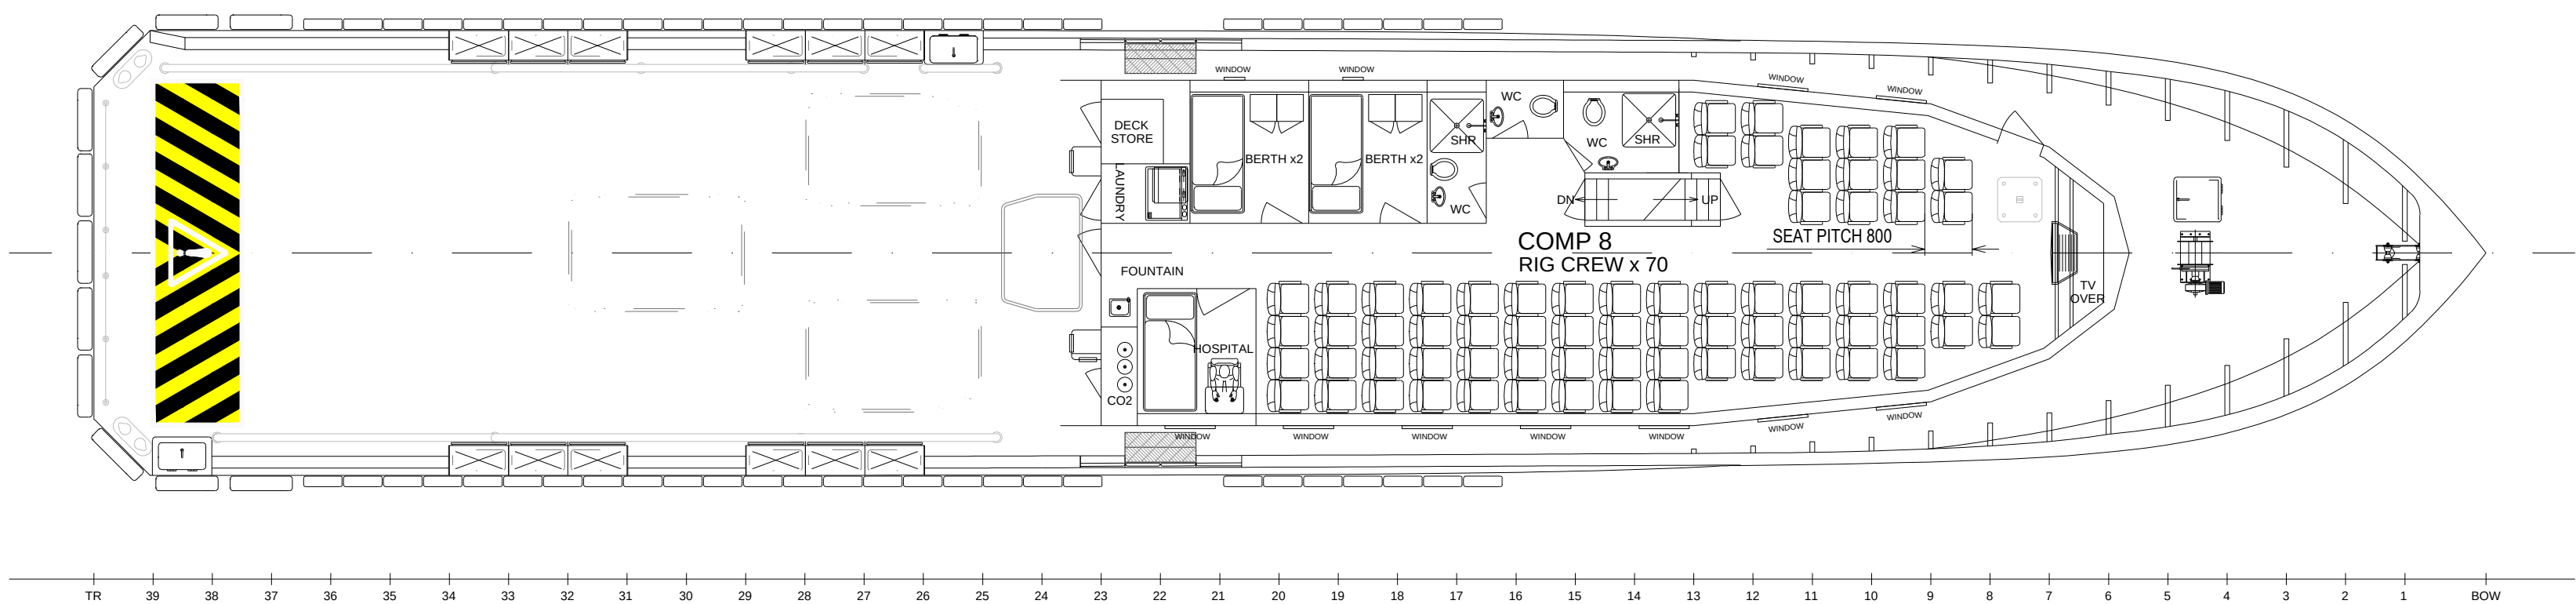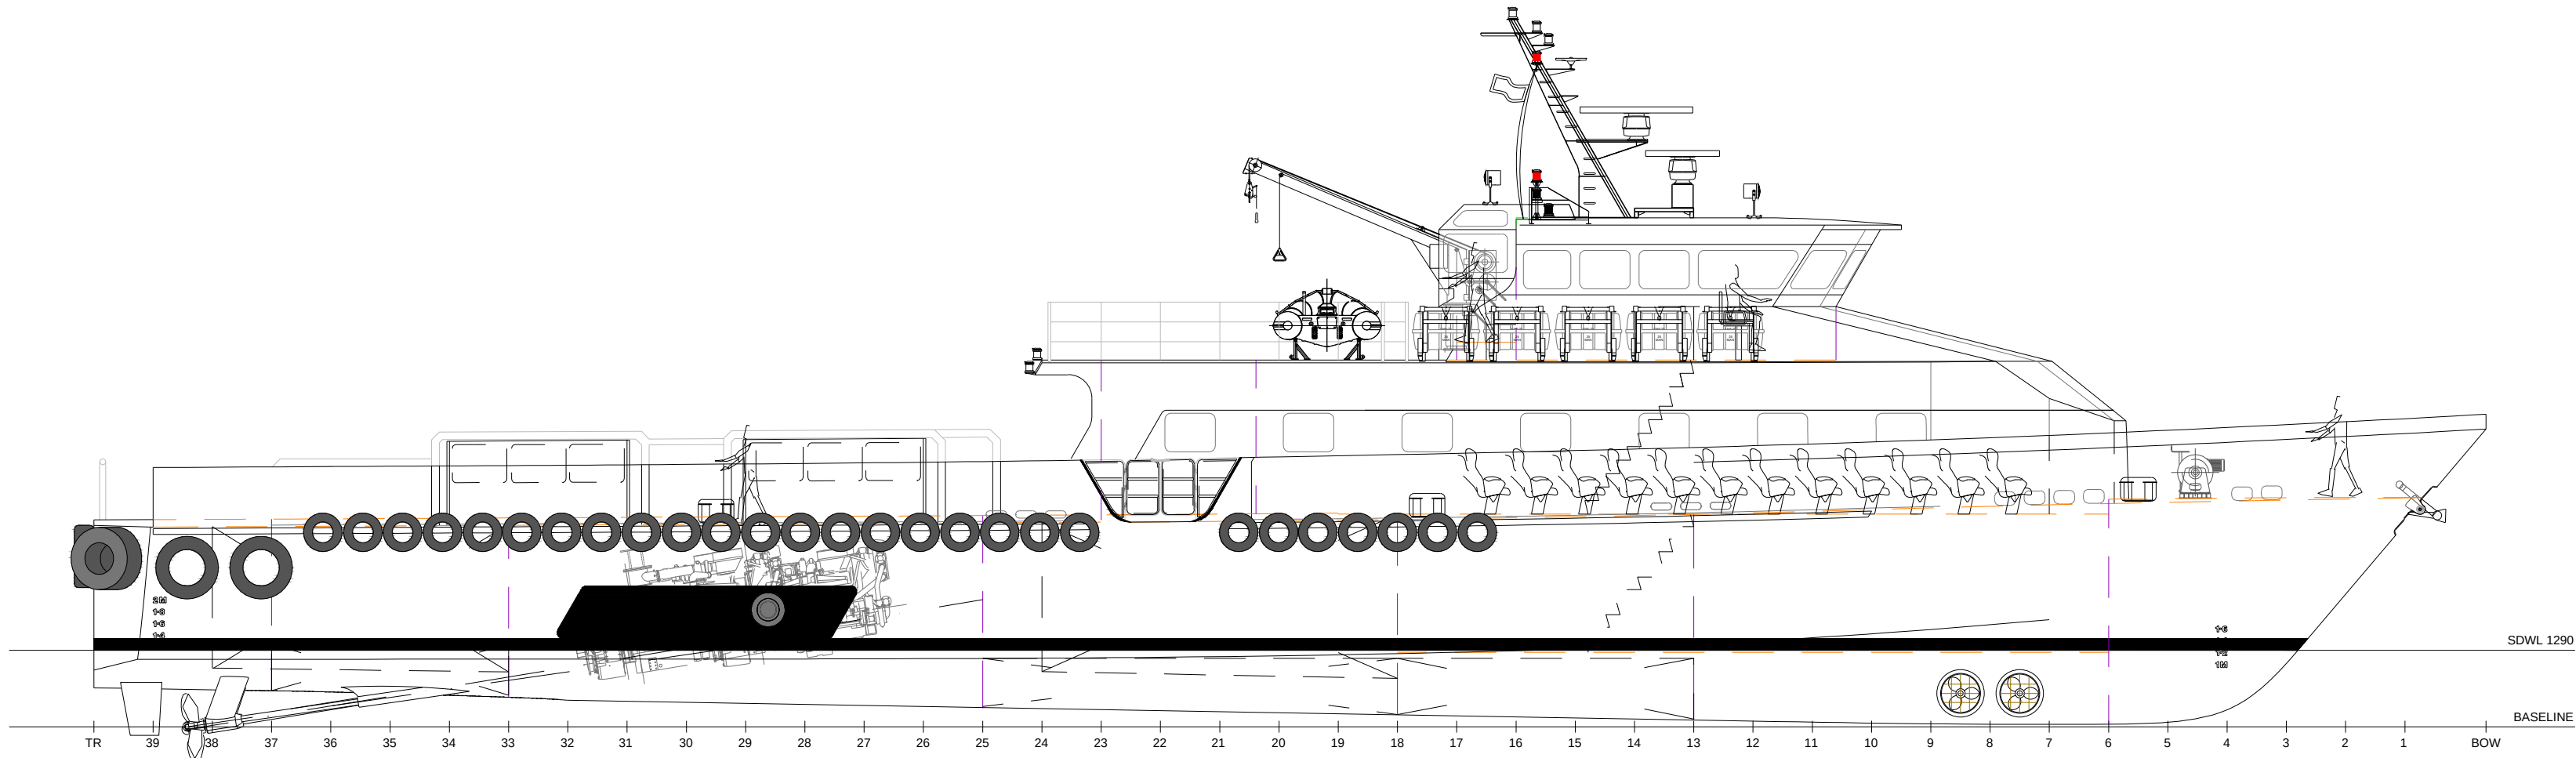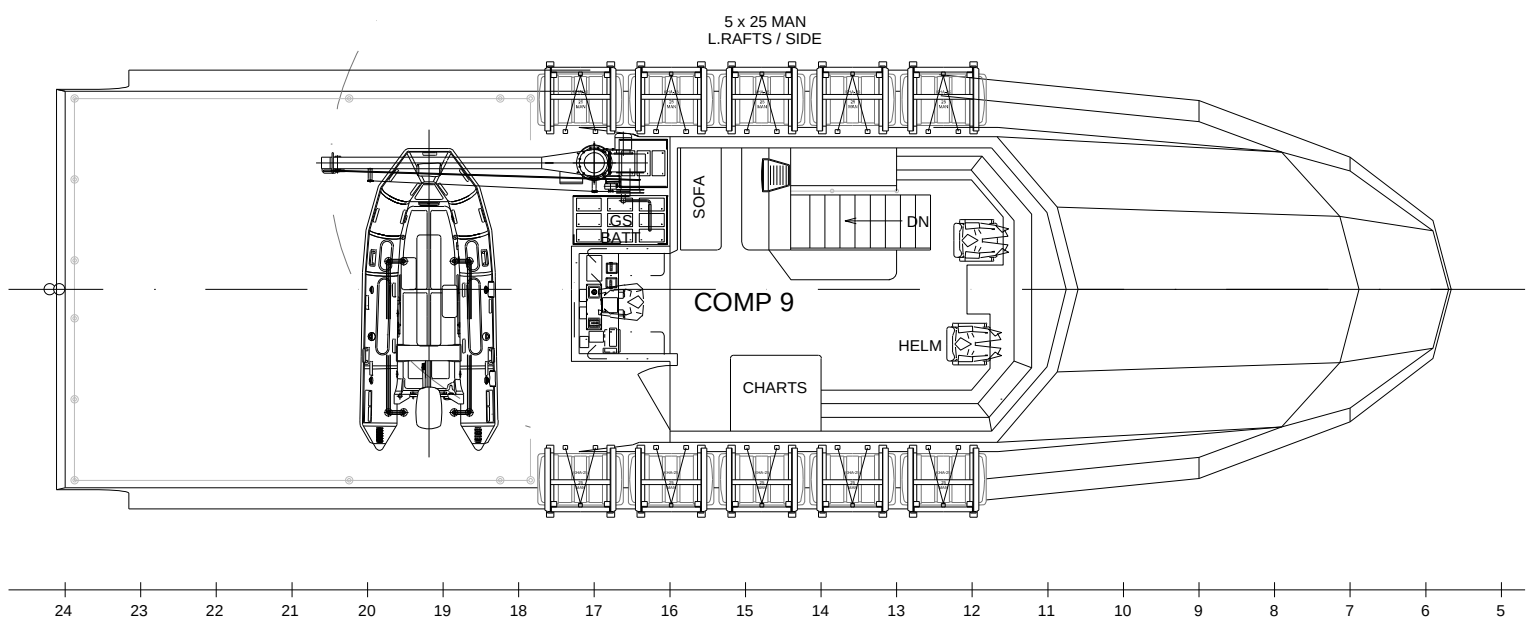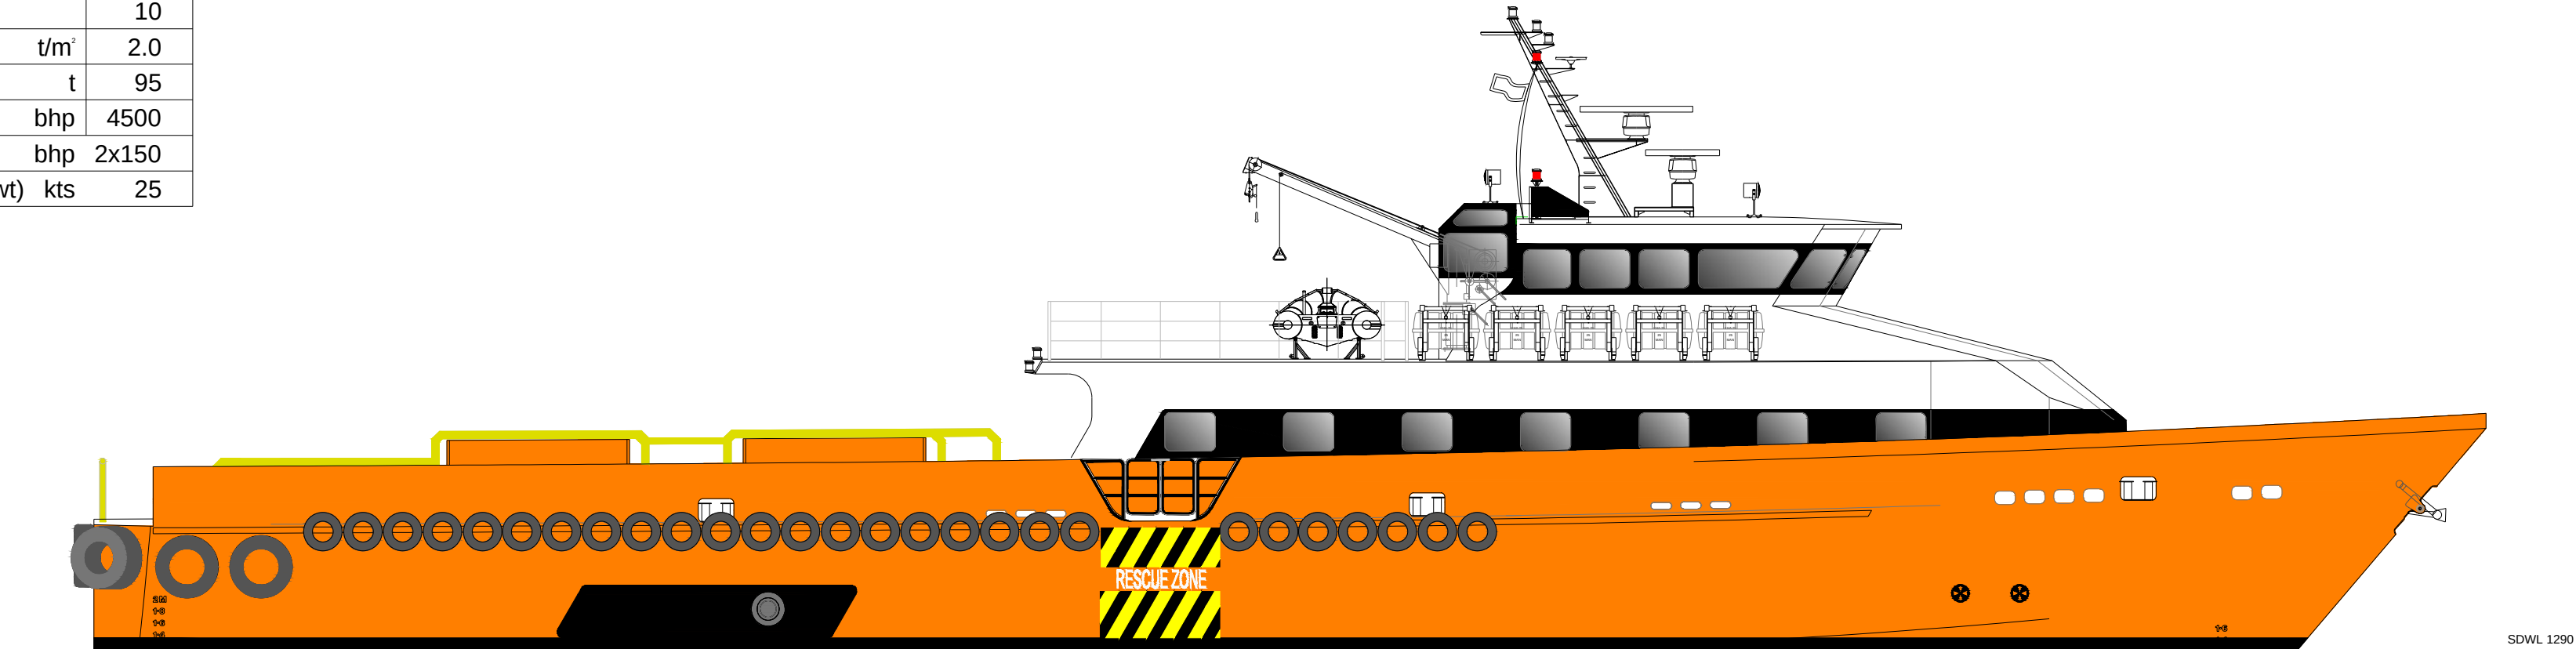

- NOTES:
1. DRAFT MARKS TO CORRELATE WITH FREEBOARD ASSIGNMENT.
 2. MAXIMUM DEAD WEIGHT TO CORRELATE WITH FINAL STABILITY BOOKLET.
 3. BOUNDARIES AND BULKHEAD INSULATION ARRANGEMENT AND DETAILS KINDLY REFER TO FIRE AND SAFETY PLAN
 4. DAMAGE STABILITY WILL BE SUBMITTED TO COMPLY WITH MSC 235(82).
 5. DOOR DETAILS ARE TO BE SUBMITTED.

FOR APPROVAL

		Strategic Marine	
LOT 5, CLARENCE BEACH ROAD HENDERSON W.A. 6166		TELEPHONE (618) 94374860 FACSIMILE (618) 94374838	
TITLE GENERAL ARRANGEMENT			
PROJECT 40.37M RIG PERSONNEL / UTILITY VESSEL		HULL NO. H356	
DRAWING REF. S578-I5-001_B		SHEET No. 1 OF 1	
SCALE 100 OR AS SHOWN		DATE 02/08/2013	
DRAWN A.TAYLOR		CHECKED M.BARNETT	APPROVED M.BARNETT
B UPDATED AS BUILT		07/03/14	C. CASTILLO G. DANIEL G. DANIEL
A ISSUED FOR APPROVAL		02/08/2013	A.TAYLOR M.BARNETT M.BARNETT
REV REVISION DETAILS		DATE	DRN CHECKED APPROVED

THIS DRAWING AND ALL INFORMATION CONTAINED WITHIN REMAIN THE SOLE PROPERTY OF SOUTHERLY DESIGNS PTY LTD NO PART MAY BE COPIED, MODIFIED OR REPRODUCED IN ANY MANNER WITHOUT THE PRIOR PERMISSION OF SOUTHERLY DESIGNS PTY LTD.